



EQUIPMENT DESCRIPTION		
VACUUM BREAKER	DFT	DFT
MOTOR	BALDOR	Two 100 % Baldor electric motors 200 HP, 460 V 60 Hz. TEFC Ser. Factor 1.15
PUMP	CARVER	Two 100% Carver Feedwater pump capacity RS6 A2x3-6 14 stage, size B, 200HP, TEFC, 460/3/60 190 GPM @ 850 PSIG, all metal seals and wear rings
DEAERATOR	BFS INDUSTRIES	BFS deaerator with 85,000 PPH capacity operating pressure 5 psig temperature 227F/ Max. allowable pressure 50 psig at 400F
OVER FLOW TRAP	WARREN CONTROLS	313 Overflow trap 131902-1 P/N 031311xxx001
LEVEL CONTROL	HONEYWELL UDC 3200	Transmitter/ Single loop controller

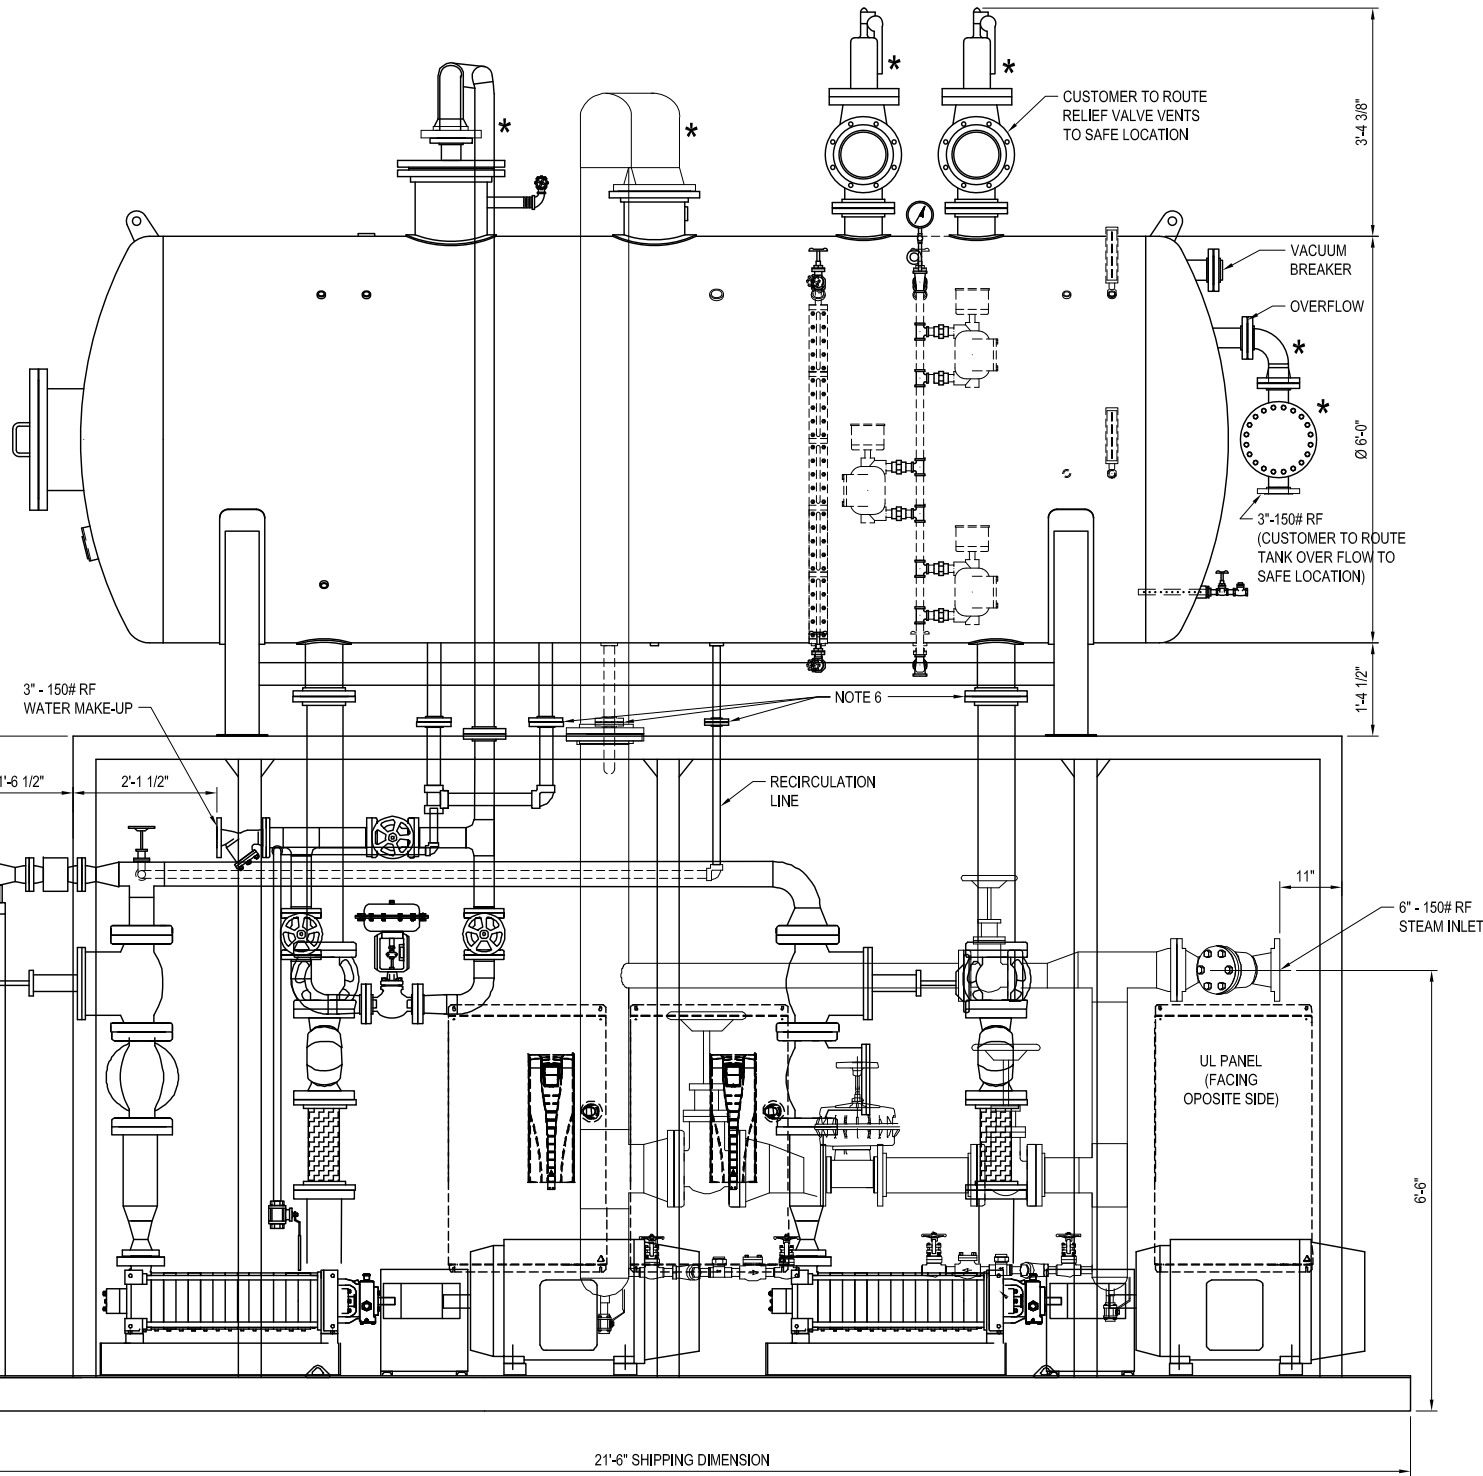

FRONT VIEW

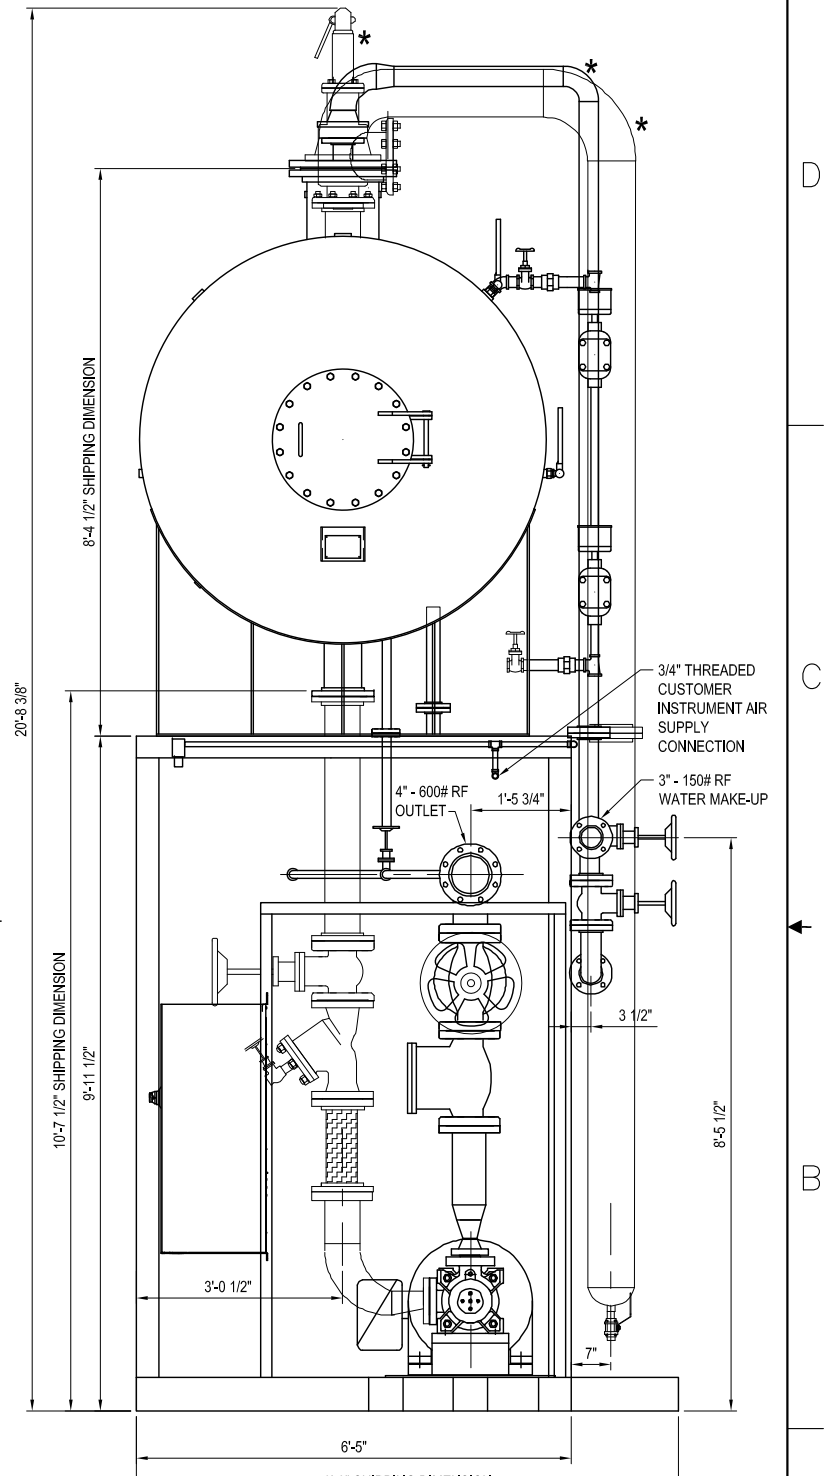

LEFT SIDE VIEW

- NOTES:**
- SOME EQUIPMENT IS OMITTED FOR CLARITY.
  - SAFETY VALVE AND STEAM PRV PIPING TO BE PROPERLY SUPPORTED BY CUSTOMER. STEAM NOZZLE LOADING TO BE LESS THAN 500#.
  - STEAM PRV SIZED FOR 150 PSI SATURATED STEAM INPUT. OTHER PRESSURES MAY REQUIRE CUSTOMER TO REDUCE PRIOR TO INDECK VALVE.
  - SOME EQUIPMENT IS ROTATED FOR CLARITY.
  - WILL SHIP IN (2) SEPARATE PARTS - TOP ASSEMBLY & BOTTOM ASSEMBLY. ADDITIONAL SMALL PARTS WILL BE SHIPPED LOOSE AND REQUIRED FIELD ASSEMBLY.
  - CUSTOMER TO RECONNECT FLANGES, DP INSTRUMENTS, AND AIR TUBING.
  - PIPE CONNECTION DIMENSIONS ARE WITHIN 1" TOLERANCE.
  - \*\* DENOTES SHIP LOOSE PARTS.

INDECK DWG. NO.  
 THIS DESIGN OR DRAWING IS NOT SOLD AND IS SUBJECT TO RECALL, REPRODUCTION OR COPYING RIGHTS ARE RESERVED SOLELY TO INDECK POWER EQUIPMENT COMPANY. THE DRAWING HAS BEEN DELIVERED AND RECEIVED ON THE EXPRESSED CONDITIONS THAT IT IS NOT USED IN ANY WAY AGAINST THE INTERESTS AND BENEFITS OF INDECK POWER EQUIPMENT COMPANY, AND THAT THIS DRAWING AND ALL COPIES OF IT WILL BE RETURNED TO INDECK POWER EQUIPMENT COMPANY IMMEDIATELY ON DEMAND, AND THAT ALL INFORMATION DISCLOSED BY THIS DRAWING TO THE HOLDER SHALL BE HELD IN CONFIDENCE.

REV	DATE	DESCRIPTION	DRWN BY	APPR BY
A	11/08/17	AS BUILT	LI	GW

**INDECK**  
 INDECK POWER EQUIPMENT COMPANY . 1111 WILLIS AVENUE . WHEELING, ILLINOIS 60090

STOCK EQUIPMENT

85,000 PPH BFS DA

ITEM 106822/106823 - GA

DATE	10/16/17	DRAWN BY	LI	REV.	A	DRAWING NUMBER	106822-01	SHEET 1
SCALE	N.T.S.	CHECKED BY	AK					